

DRAWING NUMBER

DRAWING NUMBER

DRAWING NUMBER

PLAN HOLD CORPORATION • IRVINE, CALIFORNIA

PLAN HOLD CORPORATION • IRVINE, CALIFORNIA

PLAN HOLD CORPORATION • IRVINE, CALIFORNIA

WORKSHEET NUMBER 07242

WORKSHEET NUMBER 07242

WORKSHEET NUMBER 07242

POSITION LINE OF PRINT ON THIS LINE


POSITION LINE OF PRINT ON THIS LINE

POSITION LINE OF PRINT ON THIS LINE

POSITION LINE OF PRINT ON THIS LINE

SUBCONTRACTOR SHALL PULL NEW
PLENUM CABLES TO THE NORTHWEST TELEPHONE
CLOSET AND VERTICALLY UP TO THE 1844th
FLOOR CLOSET TO SERVE CANTOR FITZGERALD
COMPANY. SEE DRAWING T2 FOR CONTINUATION
OF CABLE ROUTE INTO TOWAN SPACE.
SEE NOTE #6 FOR CABLE SPECIFICATIONS

EXISTING METROPOLITAN FIBER SYSTEMS, INC.
(AFS) JUNCTION BOX AND CONDUIT ABOVE
EXISTING SUSPENDED CEILING

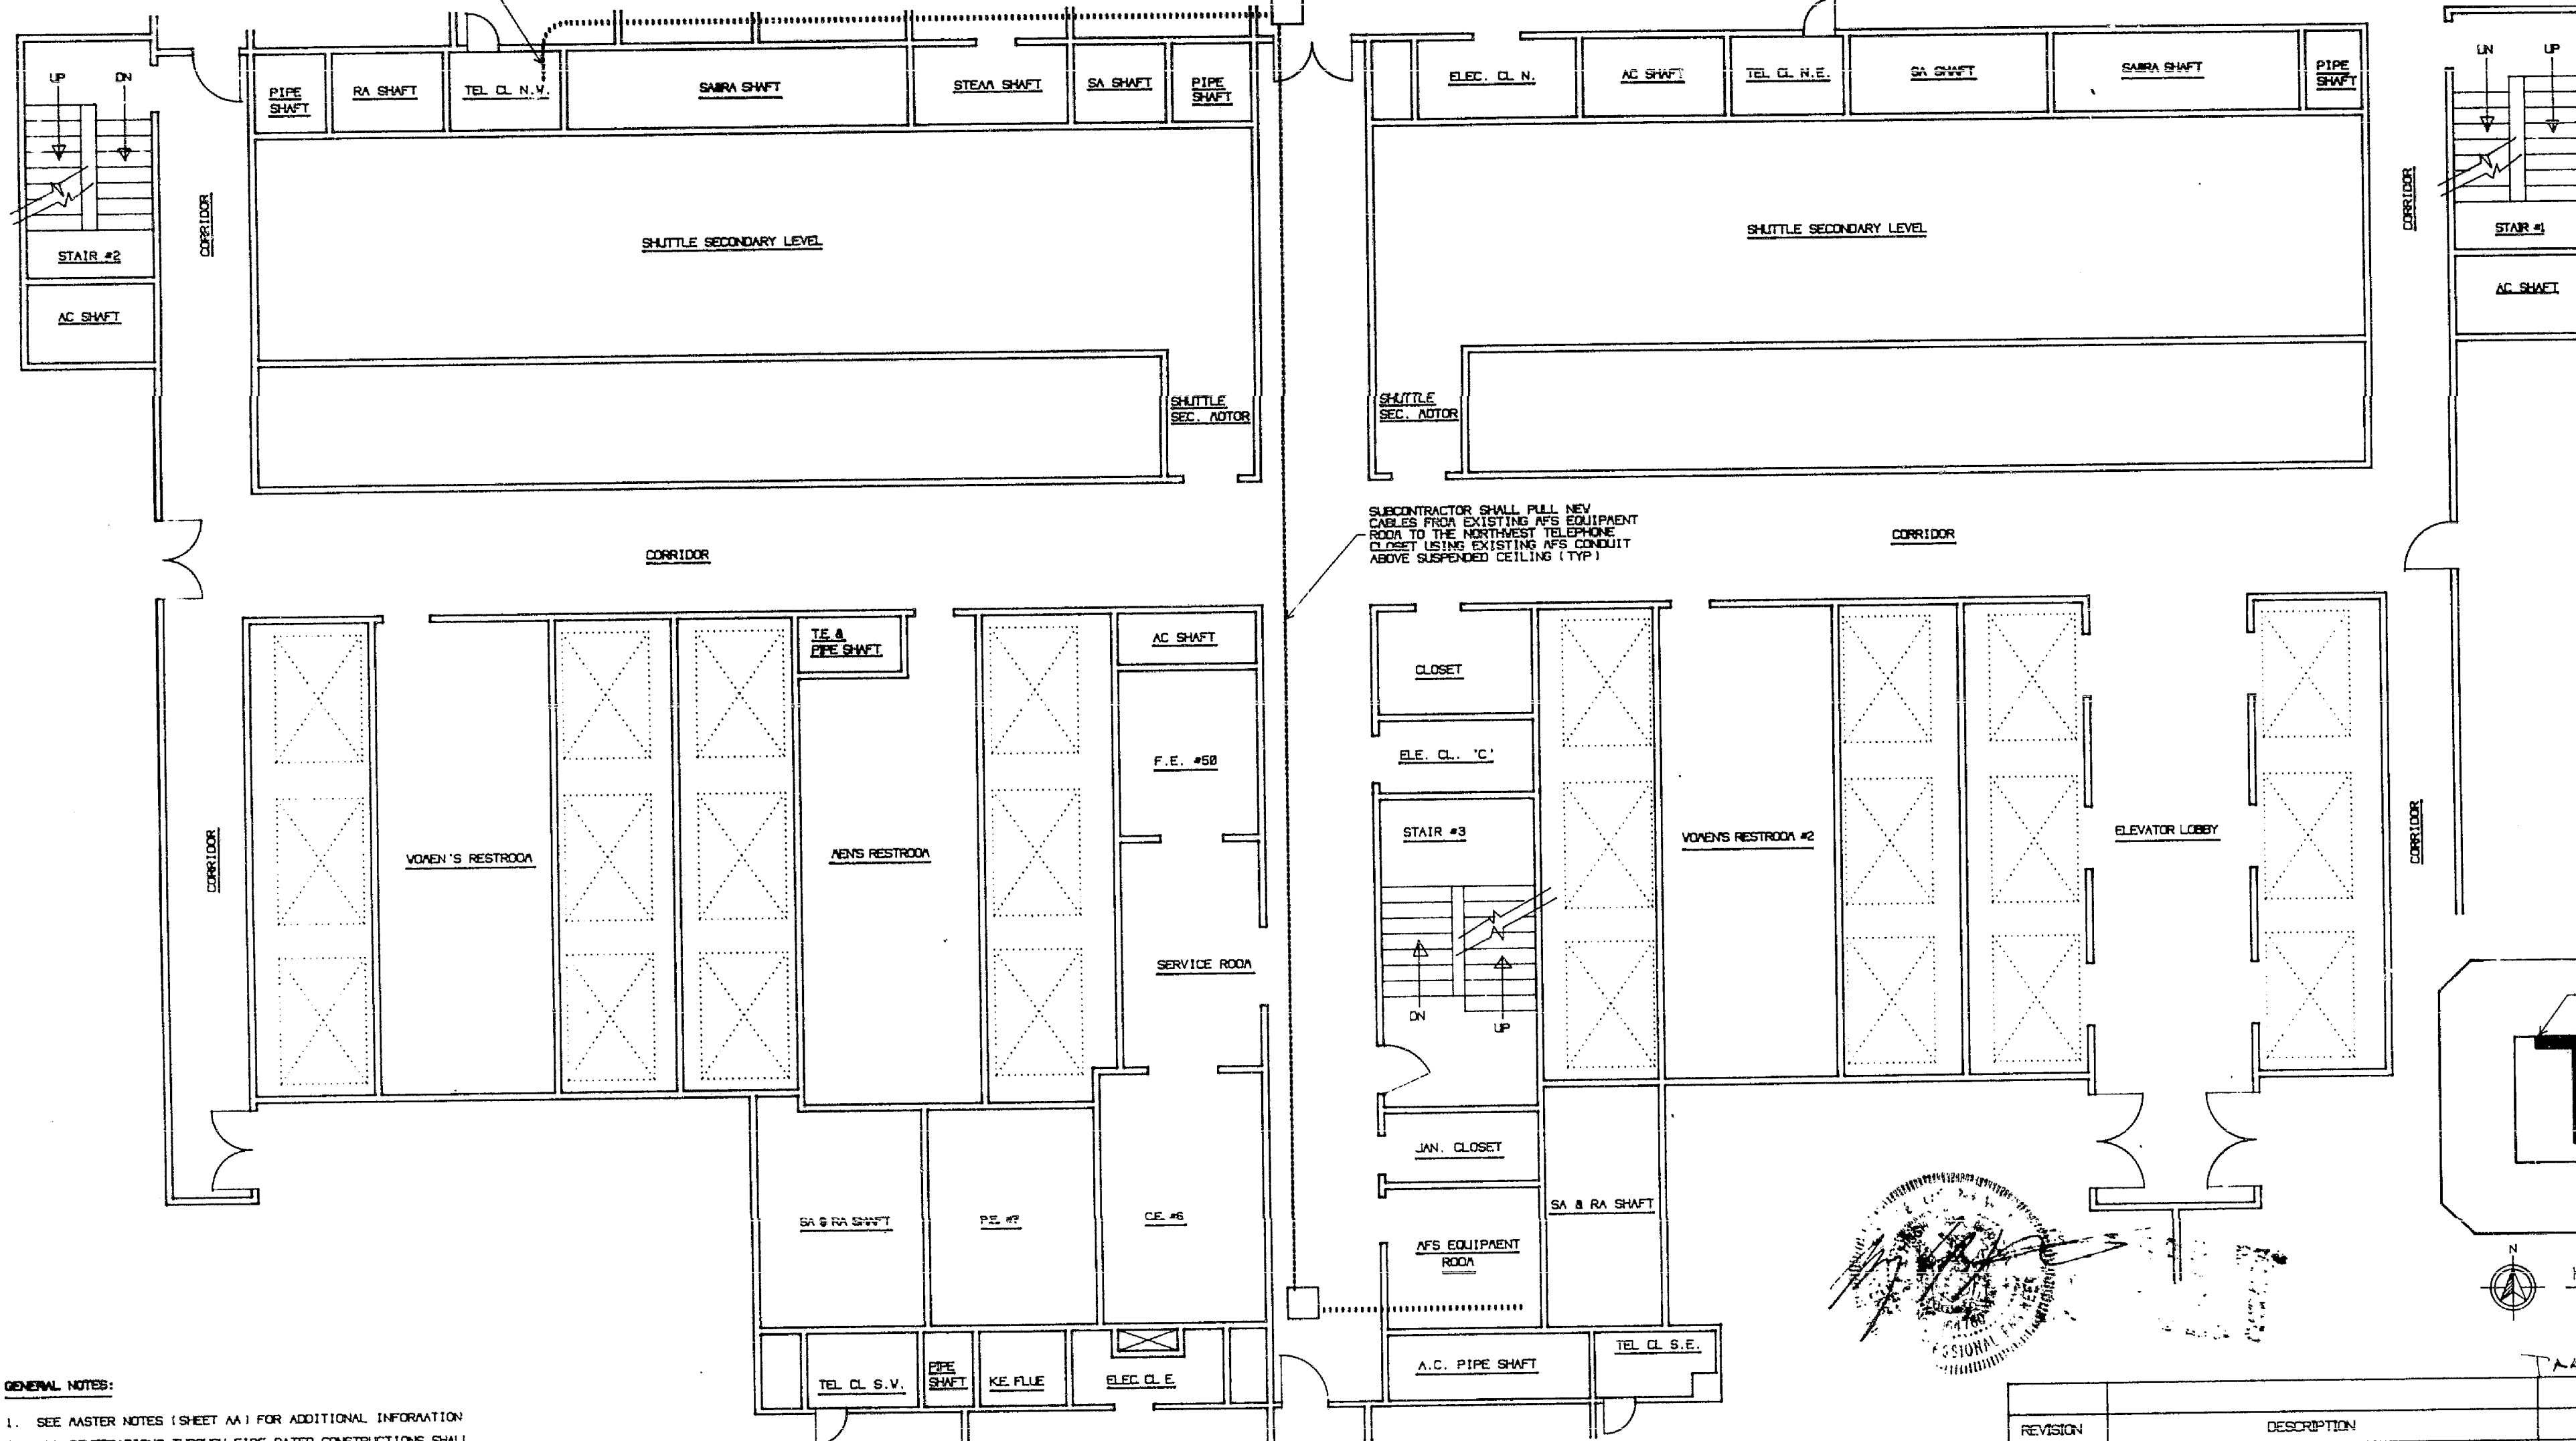

GENERAL NOTES:

- SEE MASTER NOTES (SHEET AA) FOR ADDITIONAL INFORMATION
- ALL PENETRATIONS THROUGH FIRE RATED CONSTRUCTIONS SHALL BE SLEEVED FIRE SEALED AND PATCHED.
- ALL PENETRATIONS THROUGH NON-FIRE RATED CONSTRUCTIONS SHALL BE SLEEVED PATCHED AND SEALED TO MATCH EXISTING.
- THIS IS A DIAGRAMMATIC DRAWING AND SHALL NOT BE USED FOR PRECISE MEASUREMENTS
- ALL WORK SHALL CONFORM TO NECA, LOCAL, STATE, AND PORT AUTHORITY REQUIREMENTS
- NEW CABLES SHALL BE PLENUM, 24 AWG SOLID CONDUCTOR, AS MANUFACTURED BY GVC MANUFACTURING OR APPROVED EQUAL. NUMBER OF CABLES AND PRODUCT CODE ARE AS FOLLOWS:
(2) 2101-0250-R1000 FOR 6 PAIR CABLE
(1) 2101-0250-R1000 FOR 25 PAIR CABLE
(1) 2101-0250-R1000 FOR 50 PAIR CABLE



ONE WORLD TRADE CENTER
THE CANTOR FITZGERALD SECURITIES CO.
80th FLOOR CORE PLAN - CABLE ROUTES

SCALE: 1/8" = 1'-0"

AS-BUILT

SHEET NO.

T 1

FILENAME: P25471

REVISION	DESCRIPTION	DATE	INITIAL
KIEVIT NETWORK TECHNOLOGIES, INC.			
TITLE METROPOLITAN FIBER SYSTEMS WORLD TRADE CENTER - TOWER A PROPOSED CABLE ROUTES		INFORMATION ON THIS DOCUMENT IS PROPRIETARY AND SHALL NOT BE USED, COPIED, REPRODUCED OR DISCLOSED IN WHOLE OR IN PART WITHOUT WRITTEN CONSENT OF KNT	
DRAWING NO. 07-012-1VT-P2-56-T1 PHASE 2 THE CANTOR FITZGERALD CO.		SCALE 1/8" = 1'-0"	SIZE C
ORIGIN	DATE	DRAWN	DATE
AL A	8/24/92	AL A	8/24/92
APPROVED	DATE		
AL A	8/24/92		